


LAKEVIEW DISTRICT UTILITY CROSSINGS  
CIP PROJECT No. WS-0110  
BID PLANS




ROBERTO MARTELL, MAYOR  
JACK MORROW, VICE-MAYOR  
EDGAR AYALA  
GRISIELA DIGIACOMO  
SUSANA GUASCH


JORGE C. SOTO, UTILITIES DIRECTOR  
JORGE E. CORZO, PE, CFM, TOWN ENGINEER  
ROY DANZIGER, FINANCE DIRECTOR

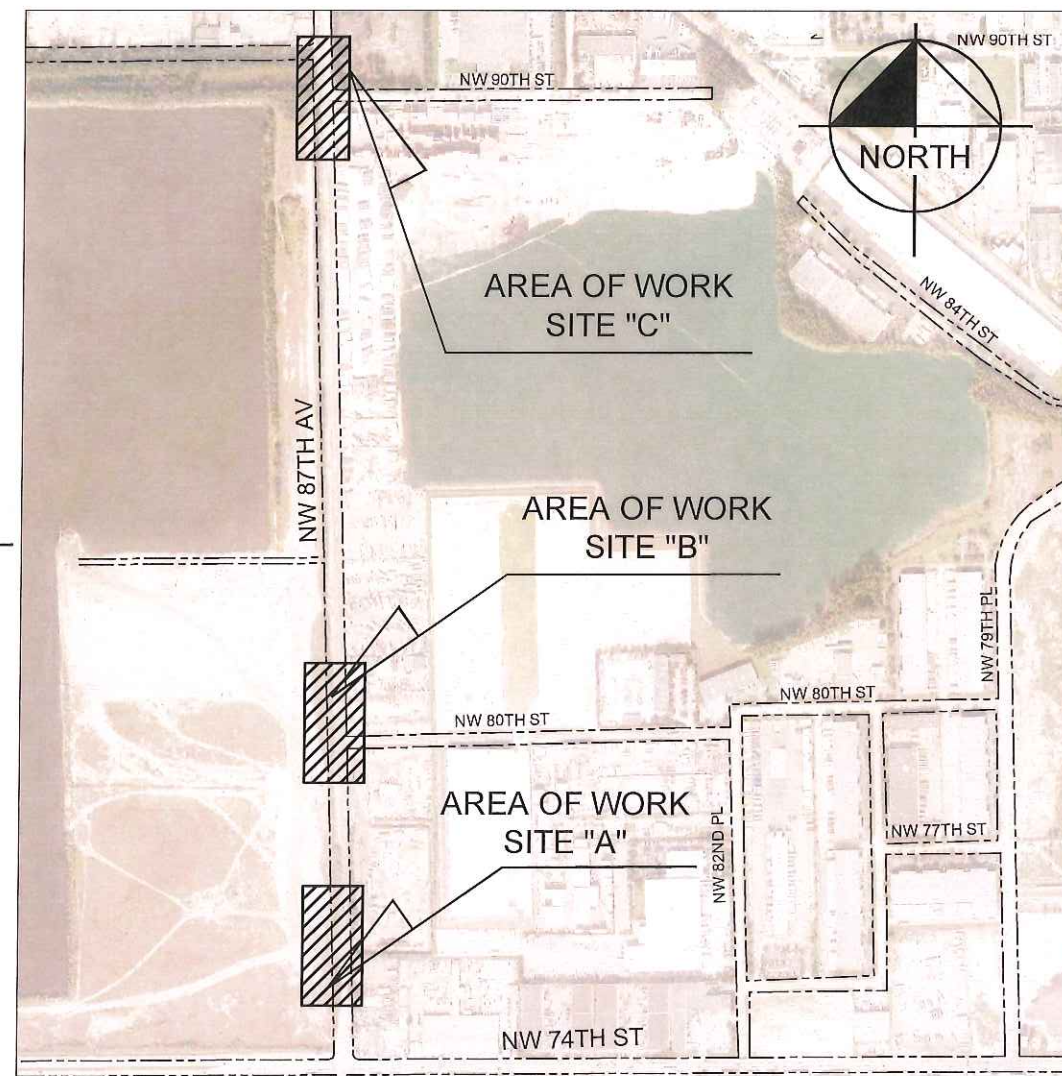

PROJECT LOCATION MAP  
UTILITY CROSSINGS (NW 87TH AVENUE)  
A PORTION OF SEC. 09 & SEC. 10 – TWP. 53 S. – RGE. 40 E.

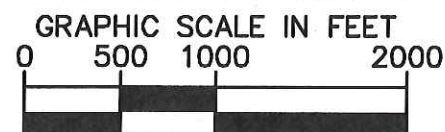


SHEET INDEX	
Sheet Number	Sheet Title
C-001	COVER SHEET
C-002	LEGEND AND PROJECT NOTES
C-003	PROJECT NOTES (CONT'D)
C-100	WATER AND SEWER KEY MAP
C-101	SITE "A" WATER MAIN PLAN AND PROFILE
C-102	SITE "B" WATER MAIN PLAN AND PROFILE I
C-103	SITE "B" WATER MAIN PLAN AND PROFILE II
C-104	SITE "B" FORCE MAIN PLAN AND PROFILE I
C-105	SITE "B" SANITARY SEWER PLAN AND PROFILE
C-106	SITE "C" WATER MAIN PLAN AND PROFILE

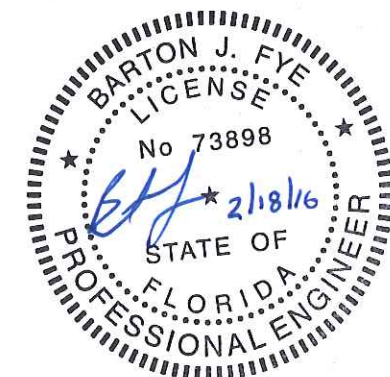**Sunshine811**

Call 811 or [www.sunshine811.com](http://www.sunshine811.com) two full business days before digging to have utilities located and marked.

*Check positive response codes before you dig!*

SHEET NUMBER <b>C-001</b>		<b>LAKEVIEW DISTRICT UTILITY CROSSINGS</b> PREPARED FOR <b>TOWN OF MEDLEY</b>		<b>FLORIDA</b>  <b>MIAMI-DADE</b>	
<b>COVER SHEET</b>					
KHA PROJECT 04-3637010	LICENSED PROFESSIONAL				
DATE FEB 2016	BARTON J. FYE				
SCALE AS SHOWN	FLORIDA LICENSE NUMBER 73898				
DESIGNED BY BJF	2/18/2016				
DRAWN BY AL/MRG					
CHECKED BY JEJ					
 <p>© 2016 KIMLEY-HORN AND ASSOCIATES, INC. 1221 BRICKELL AVENUE, SUITE 400, MIAMI, FL 33131 PHONE: 305-873-2025 WWW.KIMLEY-HORN.COM CA 00000496</p>			A	DERM. SEWER	2/1/2016 BJF
			A	CONSTRUCTION	2/17/2016 BJF
			No.	REVISIONS	DATE
					BY



Plotted By: E. Barton, Sheet Set: Installation of Water and Sewer Main Crossings, Layout: C-002, LEGEND AND PROJECT NOTES, February 18, 2016, 03:24:16pm, K:\MIA-ENVA\043637010 - medley utility crossings (as-011003)\CIVIL\CADD\Drawings\C-002 NOTES.dwg  
This document, together with the concepts and designs presented herein, is intended only for the specific purpose and client for which it was prepared. Review of and improve reference on this document without written authorization and adaptation by Kimley-Horn and Associates, Inc. and be without liability to Kimley-Horn and Associates, Inc.

## LEGEND

-----E-----	CENTERLINE
-----R/W-----	RIGHT-OF-WAY LINE
-----P-----	PROPERTY LINE
-----12-IN WM-----	EXIST. 12" WATER MAIN
-----EX FM-----	EXIST. FORCE MAIN
-----STORM-----	EXIST. STORM PIPE
-----GAS-----	EXIST. GAS MAIN
-----COM-----	EXIST. BURIED COMMUNICATIONS
-----X-----X-----	EXIST. FENCE
-----OUL-----	EXIST. OVERHEAD UTILITY LINE
BUTT.V.	BUTTERFLY VALVE
CEI/C.E.I.	CONSTRUCTION ENGINEERING INSPECTOR
DIP/D.I.P.	DUCTILE IRON PIPE
E	EAST
ELEC.	ELECTRICAL
ELEV./EL.	ELEVATION
EOR/E.O.R.	ENGINEER OF RECORD
EXIST.	EXISTING
FDOT	FLORIDA DEPARTMENT OF TRANSPORTATION
FM/F.M.	FORCE MAIN (SEWER)
FPL	FLORIDA POWER & LIGHT
FVO/F.V.O.	FLUSHING VALVE OUTLET
GV/G.V.	GATE VALVE
INV.	INVERT
LF/L.F.	LINEAR FEET
LT	LEFT (OFFSET)
MDWASD	MIAMI-DADE WATER AND SEWER DEPARTMENT
MAX.	MAXIMUM
MH/M.H.	MANHOLE
MIN.	MINIMUM
N	NORTH
NO./No.	NUMBER
OFF.	OFFSET
PROP.	PROPOSED
PVC/P.V.C.	POLYVINYL CHLORIDE
REST. J.	RESTRAINED JOINT
RT	RIGHT (OFFSET)
S	SOUTH
SAN.	SANITARY SEWER (GRAVITY)
STA.	STATION
T.O.P.	TOP OF PIPE
VERT.	VERTICAL
W	WEST
WM/W.M.	WATER MAIN

## GENERAL NOTES

- EXISTING CONDITIONS SHOWN BASED ON SURVEY DATED JULY 23, 2015 AND PREPARED BY HADONNE LAND SURVEYORS AND MAPPERS. AND UNDERGROUND UTILITY INFORMATION PROVIDED BY:
  - FPL
  - FLORIDA CITY GAS
  - AT&T/DISTRIBUTION
  - TOWN OF MEDLEY
  - MDC-PUBLIC WORKS DEPT.
  - COMCAST
  - MIAMI-DADE WATER AND SEWER DEPT.
- FUTURE ROADWAY AND UTILITY IMPROVEMENTS SHOWN ON PLANS FOR REFERENCE ONLY. IMPROVEMENTS SHOWN ARE BASED ON PLANS FOR THE STATE OF FLORIDA DEPARTMENT OF TRANSPORTATION FINANCIAL PROJECT ID 405615-3-52-01 & 405615-4-52-01, PREPARED BY R.J. BEHAR & COMPANY, INC. DATED OCTOBER 19, 2015 & FINANCIAL PROJECT ID 405615-3-56-01 AND A&P CONSULTING TRANSPORTATION ENGINEERS CORP. DATED JANUARY 29, 2016.
- CONTRACTOR SHALL CONSTRUCT ALL PROPOSED PIPE AS SHOWN IN THE PLANS UNLESS APPROVED IN A FORMAL RESPONSE TO A REQUEST FOR INFORMATION BY THE TOWN AND EOR.

## GENERAL WATER NOTES

- THE CONTRACTOR SHALL NOTIFY SUNSHINE 811 TWO FULL BUSINESS DAYS BEFORE DIGGING AND THE FOLLOWING UTILITY COMPANIES SHOULD BE NOTIFIED 48 HOURS IN ADVANCE OF EXCAVATION IN AREA:
  - FPL
  - TOWN OF MEDLEY
  - MIAMI-DADE WATER AND SEWER DEPT.
  - FLORIDA CITY GAS
  - MDC-PUBLIC WORKS DEPT.
  - AT&T/DISTRIBUTION
  - COMCAST
- UNLESS OTHERWISE NOTED, ALL WORK SHALL COMPLY WITH MIAMI-DADE WATER AND SEWER DEPARTMENT (MDWASD) DONATION STANDARD SPECIFICATIONS AND DETAILS FOR DESIGN AND CONSTRUCTION.
- ALL ELEVATIONS REFER TO NATIONAL GEODETIC VERTICAL DATUM, 1929 ADJUST.
- ALL PIPES, JOINTS, AND FITTINGS SHALL BE MECHANICALLY RESTRAINED THROUGHOUT UNLESS OTHERWISE NOTED.
- CUTTING AND PLUGGING OF EXISTING MAINS SHALL BE ACCOMPLISHED BY MECHANICALLY RESTRAINING THE PLUG OR CAP. SUFFICIENT LENGTH OF PIPE SHALL BE PROVIDED TO ENSURE THE STABILITY OF THE INSTALLATION.
- STATIONING SHOWN IS ALONG THE BASELINE OF SURVEY. GRADING SHOWN IS ALONG THE PROPOSED PIPE ALIGNMENT.
- EXACT LOCATIONS OF SERVICES TO BE DETERMINED IN THE FIELD.
- FOR REQUIREMENTS FOR MECHANICAL THRUST RESTRAINT, SEE STANDARD DETAIL GS 2.0.
- IF EVIDENCE OF POTENTIAL CONTAMINATION IS DETECTED DURING EXCAVATION, STOP EXCAVATION WORK AND NOTIFY THE TOWN OF MEDLEY AND THE ENGINEER OR RECORD. EVIDENCE OF POTENTIAL CONTAMINATION MAY INCLUDE ANY OF THE FOLLOWING: 1. ODOR 2. SOLID WASTE DEBRIS 3. SHEEN ON THE GROUNDWATER 4. STAINED OR SATURATED SOIL (SOIL THAT CONTAINS PRODUCT THAT DRAINS WHEN IT IS HANDLED OR CREATES STREAKS ON EXCAVATION TOOLS) OR 5. FREE FLOATING PRODUCT ON THE GROUNDWATER (OIL, DIESEL, GASOLINE, ETC.). MATERIAL THAT HAS ODOR, IS STAINED OR IS SATURATED MUST BE SEGREGATED ON AN IMPERMEABLE SURFACE FOR APPROPRIATE FUTURE DISPOSAL.
- ALL WATER PIPE AND FITTINGS INSTALLED UNDER THIS PROJECT MUST BE COLOR CODED WITH BLUE PAINT AS STATED IN THE FLORIDA ADMINISTRATIVE CODE, SUBPARAGRAPH 62-555.320(21)(B)3 AND AS REQUIRED BY THE FLORIDA DEPARTMENT OF ENVIRONMENTAL PROTECTION. IF PAINT IS APPLIED DURING INSTALLATION OF THE PIPE, THE PAINT SHALL BE APPLIED IN A CONTINUOUS LINE THAT RUNS PARALLEL TO THE AXIS OF THE PIPE AND THAT IS LOCATED ON THE TOP OF THE PIPE. FOR PIPES WITH AN INTERNAL DIAMETER OF 24-INCHES OR GREATER, PAINT SHALL BE APPLIED IN CONTINUOUS LINES ALONG EACH SIDE OF THE PIPE AS WELL AS ALONG THE TOP OF THE PIPE.
- USE CAUTION WHEN EXCAVATING AROUND UTILITIES PER SPECIFICATION SECTION 6.00.3.
- PAVEMENT RESTORATION TO BE DONE IN ACCORDANCE WITH MIAMI-DADE COUNTY PUBLIC WORKS DEPARTMENT REQUIREMENTS UNLESS OTHERWISE NOTED.
- LOCATION OF EXISTING FACILITIES AS SHOWN ON CONSTRUCTION DRAWINGS ARE FROM AVAILABLE RECORDS. THE ENGINEER ASSUMES NO RESPONSIBILITY OF THE FACILITIES SHOWN OR NOT SHOWN. CONTRACTOR IS TO FIELD VERIFY THE ELEVATION, TYPE OF PIPE AND LOCATION OF EXISTING FACILITIES PRIOR TO CONSTRUCTION. IF AN EXISTING FACILITY IS FOUND TO BE IN CONFLICT WITH THE PROPOSED CONSTRUCTION UPON EXCAVATION, THE CONTRACTOR SHALL IMMEDIATELY NOTIFY THE ENGINEER OF RECORD SO THAT APPROPRIATE MEASURES CAN BE TAKEN TO RESOLVE SAID CONFLICT. CONTRACTOR TO NOTIFY SUNSHINE STATE ONE CALL OF FLORIDA, INC. BY CALLING 811 AT LEAST 48 HOURS PRIOR TO EXCAVATING.
- IN AREAS WHERE THE CONTRACTOR ELECTS TO PERFORM DEWATERING AS PART OF THE WORK, THE CONTRACTOR SHALL BE FULLY RESPONSIBLE TO PROVIDE RELATED PROFESSIONAL SERVICES, PREPARE APPLICATION DOCUMENTS, SUBMIT AND OBTAIN ANY AND ALL REQUIRED DEWATERING/CONTAMINATION PERMIT APPROVALS (INCLUDING ANY ANCILLARY PERMITS THAT MAY BE REQUIRED, I.E. FROM R.E.R. WATER CONTROL OR POLLUTION CONTROL) PRIOR TO COMMENCING THE WORK AND AT NO ADDITIONAL CONTRACT TIME OR COST TO THE DEPARTMENT.
- THE CONTRACTOR IS RESPONSIBLE FOR IMPLEMENTATION AND MAINTENANCE OF EROSION CONTROL MEASURES AS REQUIRED BY THE MUNICIPALITY OR ANY OTHER REGULATORY AUTHORITY. THE CONTRACTOR SHALL ALSO PROVIDE ANY ADDITIONAL EROSION CONTROL MEASURES (E.G. HYDROSEEDING MULCHING OF STRAW, SAND BAGGING, DIVERSION DITCHES, ETC) DICTATED BY FIELD CONDITIONS TO PREVENT EROSION OR THE INTRUSION OF DIRT, MUD, OR DEBRIS INTO EXISTING PUBLIC STREETS, WATERWAYS, OR ONTO ADJACENT PROPERTIES DURING ANY PHASE OF CONSTRUCTION OPERATIONS.
- THE CONTRACTOR SHALL BE RESPONSIBLE FOR OBTAINING A FLORIDA DEPARTMENT OF ENVIRONMENTAL PROTECTION NPDES GENERIC PERMIT FOR STORMWATER DISCHARGE FROM LARGE AND SMALL CONSTRUCTION ACTIVITIES PERMIT (GCP) AND A NOTICE OF INTENT (NOI) TO USE SAID GENERIC PERMIT AS PROVIDED IN SUBSECTION 62-621.300(4), F.A.C. PURSUANT TO THE STATE'S FEDERALLY APPROVED NATIONAL POLLUTANT DISCHARGE ELIMINATION SYSTEM STORMWATER REGULATORY PROGRAM (NPDES). THE CONTRACTOR SHALL BE FULLY RESPONSIBLE TO PROVIDE RELATED PROFESSIONAL SERVICES, PREPARE APPLICATION DOCUMENTS AND OBTAIN ALL REQUIRED APPROVALS PRIOR TO COMMENCEMENT OF THE WORK AND AT NO ADDITIONAL CONTRACT TIME OR COST TO THE DEPARTMENT.

## THE FOLLOWING ARE REQUIREMENTS PER DEPARTMENT OF HEALTH

### WATER MAIN HORIZONTAL SEPARATIONS

- SEPARATIONS SHALL BE MEASURED OUTSIDE EDGE TO OUTSIDE EDGE.
- BETWEEN WATER MAINS AND, STORM SEWERS, STORMWATER FORCE MAINS, OR RECLAIMED WATER LINES, SHALL BE 3 FT. MINIMUM.
- BETWEEN WATER MAINS AND VACUUM TYPE SEWER PREFERABLY 10 FT. AND AT LEAST 3 FT. MINIMUM.
- GRAVITY OR PRESSURE SANITARY SEWERS, WASTEWATER FORCE MAINS OR RECLAIMED WATER PREFERABLY 10 FT. AND AT LEAST 6 FT. MAY BE REDUCED TO 3 FT. WHERE BOTTOM OF WATER MAIN IS AT LEAST 6 INCHES ABOVE TOP OF SEWER.
- 10 FT. OF ANY PART OF ON-SITE SEWER TREATMENT OR DISPOSAL SYSTEM.

### WATER MAIN VERTICAL SEPARATIONS

- SEPARATIONS BETWEEN WATER MAINS AND GRAVITY SEWER, VACUUM TYPE SEWER, OR STORM SEWERS, TO BE PREFERABLY 12 INCHES, OR AT LEAST 6 INCHES ABOVE, OR AT LEAST 12 INCHES IF BELOW.\*
- PRESSURE SANITARY SEWER, WASTEWATER OR STORM WATER FORCE MAIN, OR RECLAIMED WATER, AT LEAST 12 INCHES ABOVE OR BELOW.\*


\* NOTE: CENTER 1 - FULL LENGTH OF WATER MAIN PIPE AT CROSSINGS; ALTERNATIVELY ARRANGE PIPES SO JOINTS ARE AT LEAST 3 FEET FROM JOINTS IN VACUUM, STORM OR STORM FORCE MAINS. AT LEAST 6 FEET FROM JOINTS IN GRAVITY OF PRESSURE SEWERS, WASTEWATER FORCE MAINS OR RECLAIMED WATER.

### TRENCH PROTECTION

TRENCH EXCAVATION PROTECTION SHALL BE ACCOMPLISHED AS REQUIRED BY THE PROVISIONS OF, PART 1926, SUBPART P, EXCAVATIONS, TRENCHING AND SHORING OF THE OCCUPATIONAL SAFETY AND HEALTH ADMINISTRATIONS STANDARDS AND INTERPRETATIONS.

## TOWN OF MEDLEY MEDLEY WATER AND SEWER NOTES

- CONTRACTOR MUST CALL MEDLEY UTILITIES DEPARTMENT INSPECTION DIVISION TO ARRANGE FOR A PERMIT AND PRE-CONSTRUCTION MEETING 48 HOURS PRIOR TO PROPOSED START OF CONSTRUCTION. (TELEPHONE NO. (305) 889-1915)
- MEDLEY UTILITIES DEPARTMENT PERSONNEL WILL INSPECT ALL FACILITIES APPROVED BY THIS DEPARTMENT. ALL OTHER REQUIREMENTS OF THE PERMITTING AGENCY SHALL BE IN ACCORDANCE WITH THEIR STANDARDS AND REQUIREMENTS.
- WORK PERFORMED UNDER THIS PROJECT WILL NOT BE CONSIDERED COMPLETE UNTIL FINAL ACCEPTANCE OF THE SYSTEM BY THE MEDLEY UTILITIES DEPARTMENT AND UNTIL THE FOLLOWING DOCUMENTS ARE RECEIVED AND APPROVED BY THE DEPARTMENT:
  - EASEMENTS, IF REQUIRED
  - CONTRACTOR'S WAIVER AND RELEASE OF LIEN
  - ABSOLUTE BILL OF SALE
  - A CONTRACTOR'S LETTER OF WARRANTY (I.E., LETTER AGREEMENT)
  - AS-BUILT DRAWINGS:
    - TWO 11" X 17" "AS-BUILT" DRAWINGS SHOWING SPECIFIC LOCATIONS, DEPTHS, ETC., OF ALL WATER FACILITIES AS LOCATED BY A LICENSED SURVEYOR WHICH HAVE BEEN SIGNED AND SEALED BY A REGISTERED SURVEYOR OR ENGINEER OF RECORD, AND ENDORSED BY THE CONTRACTOR.
    - AN ELECTRONIC COPY IN PDF FORMAT OF THE SIGNED AND SEALED "AS-BUILT" DRAWINGS.
    - AN ELECTRONIC COPY OF THE "AS-BUILT" DRAWINGS IN CAD (DWG) FORMAT WITH ALL WATER FACILITIES LOCATED IN THE FLORIDA EAST FIPS 0901 STATE PLANE COORDINATE SYSTEM (NAD83)
    - A GEOGRAPHIC INFORMATION SYSTEMS (GIS) FORMAT "AS-BUILT" (SHAPEFILE) OF THE IMPROVEMENTS USING THE SCHEMA PROVIDED BY THE MEDLEY UTILITIES DEPARTMENT. (TELEPHONE NO. (305) 889-1915)

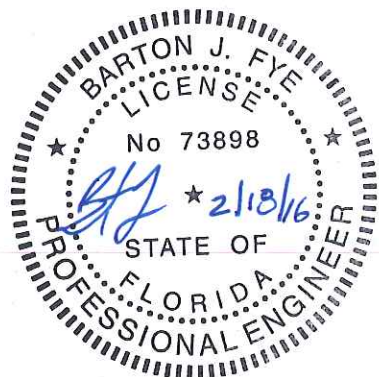

Call 811 or www.sunshine811.com two full business days before digging to have utilities located and marked.

Check positive response codes before you dig!


KHA PROJECT 043637010	DATE FEB 2016	SCALE AS SHOWN	DESIGNED BY BUF	DRAWN BY AL/ARG	CHECKED BY JEU	LICENSED PROFESSIONAL BARTON J. FYE FLORIDA LICENSE NUMBER 73898 2/18/2016	DERM SEWER CONSTRUCTION	2/1/2016	BUF
								2/17/2016	BUF
LEGEND AND PROJECT NOTES							REVSIONS		DATE
LAKEVIEW DISTRICT UTILITY CROSSINGS PREPARED FOR TOWN OF MEDLEY							No.		BY
MIAMI-DADE FLORIDA									
SHEET NUMBER C-002									



Plotted By: Fye, Barton Sheet Set: Installation of Water and Sewer Main Crossings, Layout: C-003 PROJECT NOTES (CONT'D) February 18, 2016 03:24:20pm K:\MIA-ENV\043637010 - medley utility crossings (see 0110.03) CIVIL\ADD\plansheets\C-002 NOTES.dwg  
This document, together with the concepts and designs presented herein, as an instrument of service, is intended only for the specific purpose and client for which it was prepared. Release of and improper reliance on this document without written authorization by Kimley-Horn and Associates, Inc. shall be without liability to Kimley-Horn and Associates, Inc.

GENERAL SEWER NOTES

1. THE CONTRACTOR SHALL NOTIFY SUNSHINE 811 TWO FULL BUSINESS DAYS BEFORE DIGGING AND THE FOLLOWING UTILITY COMPANIES SHOULD BE NOTIFIED 48 HOURS IN ADVANCE OF EXCAVATION IN AREA:
  - FPL
  - TOWN OF MEDLEY
  - MIAMI-DADE WATER AND SEWER DEPT.
  - FLORIDA CITY GAS
  - MDC-PUBLIC WORKS DEPT.
  - AT&T/DISTRIBUTION
  - COMCAST
2. UNLESS OTHERWISE NOTED, ALL WORK SHALL COMPLY WITH MIAMI-DADE WATER AND SEWER DEPARTMENT (MDWASD) DONATION STANDARD SPECIFICATIONS AND DETAILS FOR DESIGN AND CONSTRUCTION.
3. ALL ELEVATIONS REFER TO NATIONAL GEODETIC VERTICAL DATUM, 1929 ADJUST.
4. ALL FORCE MAIN PIPES, JOINTS, AND FITTINGS SHALL BE MECHANICALLY RESTRAINED THROUGHOUT UNLESS OTHERWISE NOTED.
5. CUTTING AND PLUGGING OF EXISTING MAINS SHALL BE ACCOMPLISHED BY MECHANICALLY RESTRAINING THE PLUG OR CAP. SUFFICIENT LENGTH OF PIPE SHALL BE PROVIDED TO ENSURE THE STABILITY OF THE INSTALLATION.
6. STATIONING SHOWN IS ALONG THE BASELINE OF SURVEY. GRADING SHOWN IS ALONG THE PROPOSED ALIGNMENT.
7. FOR REQUIREMENTS FOR MECHANICAL THRUST RESTRAINT, SEE STANDARD DETAIL GS 2.0.
8. IF EVIDENCE OF POTENTIAL CONTAMINATION IS DETECTED DURING EXCAVATION, STOP EXCAVATION WORK AND NOTIFY THE TOWN OF MEDLEY AND THE ENGINEER OF RECORD. EVIDENCE OF POTENTIAL CONTAMINATION MAY INCLUDE ANY OF THE FOLLOWING: 1. ODOR 2. SOLID WASTE DEBRIS 3. SHEEN ON THE GROUNDWATER 4. STAINED OR SATURATED SOIL (SOIL THAT CONTAINS PRODUCT THAT DRAINS WHEN IT IS HANDLED OR CREATES STREAKS ON EXCAVATION TOOLS) OR 5. FREE FLOATING PRODUCT ON THE GROUNDWATER (OIL, DIESEL, GASOLINE, ETC.). MATERIAL THAT HAS ODOR, IS STAINED OR IS SATURATED MUST BE SEGREGATED ON AN IMPERMEABLE SURFACE FOR APPROPRIATE FUTURE DISPOSAL.
9. ALL SEWER MAIN INSTALLED UNDER THIS PROJECT MUST BE CLEARLY IDENTIFIED AS REQUIRED BY THE FLORIDA DEPARTMENT OF ENVIRONMENTAL PROTECTION AND THE RECOMMENDED STANDARDS FOR WASTEWATER FACILITIES 49.7. CONTRACTOR SHALL USE GREEN PAINT (Corboline, Color No. 2369) TO IDENTIFY FORCE MAINS. IF PAINT IS APPLIED DURING INSTALLATION OF THE PIPE, THE PAINT SHALL BE APPLIED IN A CONTINUOUS LINE THAT RUNS PARALLEL TO THE AXIS OF THE PIPE AND THAT IS LOCATED ON THE TOP OF THE PIPE. FOR PIPES WITH AN INTERNAL DIAMETER OF 24-INCHES OR GREATER, PAINT SHALL BE APPLIED IN CONTINUOUS LINES ALONG EACH SIDE OF THE PIPE AS WELL AS ALONG THE TOP OF THE PIPE.
10. USE CAUTION WHEN EXCAVATING AROUND UTILITIES PER SPECIFICATION SECTION 6.00.3.
11. PAVEMENT RESTORATION TO BE DONE IN ACCORDANCE WITH MIAMI-DADE COUNTY PUBLIC WORKS DEPARTMENT REQUIREMENTS UNLESS OTHERWISE NOTED.
12. LOCATION OF EXISTING FACILITIES AS SHOWN ON CONSTRUCTION DRAWINGS ARE FROM AVAILABLE RECORDS. THE ENGINEER ASSUMES NO RESPONSIBILITY OF THE FACILITIES SHOWN OR NOT SHOWN. CONTRACTOR IS TO FIELD VERIFY THE ELEVATION, TYPE OF PIPE AND LOCATION OF EXISTING FACILITIES PRIOR TO CONSTRUCTION. IF AN EXISTING FACILITY IS FOUND TO BE IN CONFLICT WITH THE PROPOSED CONSTRUCTION UPON EXCAVATION, THE CONTRACTOR SHALL IMMEDIATELY NOTIFY THE ENGINEER OF RECORD SO THAT APPROPRIATE MEASURES CAN BE TAKEN TO RESOLVE SAID CONFLICT. CONTRACTOR TO NOTIFY SUNSHINE STATE ONE CALL OF FLORIDA, INC. BY CALLING 811 AT LEAST 48 HOURS PRIOR TO EXCAVATING
13. IN AREAS WHERE THE CONTRACTOR ELECTS TO PERFORM DEWATERING AS PART OF THE WORK, THE CONTRACTOR SHALL BE FULLY RESPONSIBLE TO PROVIDE RELATED PROFESSIONAL SERVICES, PREPARE APPLICATION DOCUMENTS, SUBMIT AND OBTAIN ANY AND ALL REQUIRED DEWATERING/CONTAMINATION PERMIT APPROVALS (INCLUDING ANY ANCILLARY PERMITS THAT MAY BE REQUIRED, I.E. FROM R.E.R. WATER CONTROL OR POLLUTION CONTROL) PRIOR TO COMMENCING THE WORK AND AT NO ADDITIONAL CONTRACT TIME OR COST TO THE DEPARTMENT.
14. THE CONTRACTOR IS RESPONSIBLE FOR IMPLEMENTATION AND MAINTENANCE OF EROSION CONTROL MEASURES AS REQUIRED BY THE MUNICIPALITY OR ANY OTHER REGULATORY AUTHORITY. THE CONTRACTOR SHALL ALSO PROVIDE ANY ADDITIONAL EROSION CONTROL MEASURES (E.G. HYDROSEEDING MULCHING OF STRAW, SAND BAGGING, DIVERSION DITCHES, ETC) DICTATED BY FIELD CONDITIONS TO PREVENT EROSION OR THE INTRUSION OF DIRT, MUD, OR DEBRIS INTO EXISTING PUBLIC STREETS, WATERWAYS, OR ONTO ADJACENT PROPERTIES DURING ANY PHASE OF CONSTRUCTION OPERATIONS.
15. THE CONTRACTOR SHALL BE RESPONSIBLE FOR OBTAINING A FLORIDA DEPARTMENT OF ENVIRONMENTAL PROTECTION NPDES GENERIC PERMIT FOR STORMWATER DISCHARGE FROM LARGE AND SMALL CONSTRUCTION ACTIVITIES PERMIT (GCP) AND A NOTICE OF INTENT (NOI) TO USE SAID GENERIC PERMIT AS PROVIDED IN SUBSECTION 62-621.300(4), F.A.C. PURSUANT TO THE STATE'S FEDERALLY APPROVED NATIONAL POLLUTANT DISCHARGE ELIMINATION SYSTEM STORMWATER REGULATORY PROGRAM (NPDES). THE CONTRACTOR SHALL BE FULLY RESPONSIBLE TO PROVIDE RELATED PROFESSIONAL SERVICES, PREPARE APPLICATION DOCUMENTS AND OBTAIN ALL REQUIRED APPROVALS PRIOR TO COMMENCEMENT OF THE WORK AND AT NO ADDITIONAL CONTRACT TIME OR COST TO THE DEPARTMENT.

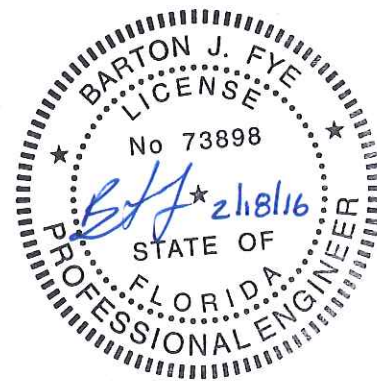

R.E.R. NOTES ON WATER-SEWER INSTALLATION

1. A HORIZONTAL DISTANCE OF AT LEAST 6 FEET, AND PREFERABLY 10 FEET (OUTSIDE TO OUTSIDE), SHALL BE MAINTAINED BETWEEN GRAVITY OR PRESSURE SEWER PIPES AND WATER PIPES. THE MINIMUM HORIZONTAL SEPARATION CAN BE REDUCED TO 3 FEET FOR VACUUM-TYPE SEWERS OR FOR GRAVITY SEWERS WHERE THE BOTTOM OF THE SEWER PIPE IS AT LEAST 6 INCHES BELOW THE BOTTOM OF THE WATER PIPE. WHEN THE ABOVE SPECIFIED HORIZONTAL DISTANCE CRITERIA CANNOT BE MET DUE TO AN EXISTING UNDERGROUND FACILITY CONFLICT, SMALLER SEPARATIONS ARE ALLOWED IF:
  - A) THE SEWER PIPES ARE DESIGNED AND CONSTRUCTED EQUAL TO THE WATER PIPE AND PRESSURE TESTED AT 150 PSI.
  - B) THE SEWER IS ENCASED IN A WATERTIGHT CARRIER PIPE OR CONCRETE.
  - C) THE TOP OF THE SEWER IS AT LEAST 18 INCHES BELOW THE BOTTOM OF THE WATER PIPE.
2. A VERTICAL DISTANCE OF AT LEAST 12 INCHES (OUTSIDE TO OUTSIDE) SHALL BE MAINTAINED BETWEEN ANY WATER AND SEWER MAINS WITH SEWER PIPES PREFERABLY CROSSING UNDER WATER MAINS. THE MINIMUM VERTICAL SEPARATION CAN BE REDUCED TO 6 INCHES FOR VACUUM-TYPE SEWERS OR FOR GRAVITY SEWERS WHERE THE SEWER PIPE IS BELOW THE WATER MAIN. THE CROSSING SHALL BE ARRANGED SO THAT ALL WATER MAIN JOINTS ARE AT LEAST 6 FEET FROM ALL JOINTS IN GRAVITY AND PRESSURE SEWER PIPES. THE DISTANCE CAN BE REDUCED TO 3 FEET FOR VACUUM-TYPE SEWERS. WHEN THE ABOVE SPECIFIED VERTICAL DISTANCE CRITERIA CANNOT BE MET DUE TO AN EXISTING UNDERGROUND FACILITY CONFLICT, SMALLER SEPARATIONS ARE ALLOWED IF:
  - A) THE SEWER PIPES ARE DESIGNED AND CONSTRUCTED EQUAL TO THE WATER PIPE AND PRESSURE TESTED AT 150 PSI.
  - B) THE SEWER IS ENCASED IN A WATERTIGHT CARRIER PIPE OR CONCRETE.
3. IN HIGHLY CONGESTED AREAS, WHERE EITHER WATER OR SEWER FACILITIES ARE EXISTING AND THE SEPARATION REQUIREMENTS CANNOT BE MET, SPECIAL CONSIDERATION MAY BE GIVEN SUBJECT TO SUBMITTAL OF DOCUMENTATION SHOWING THAT THE PROPOSED ALTERNATIVE WILL RESULT IN AN EQUIVALENT LEVEL OF RELIABILITY AND PUBLIC HEALTH PROTECTION.
4. THE MAXIMUM ALLOWABLE EXFILTRATION RATE OF GRAVITY SANITARY SEWERS CONSTRUCTED IN A PUBLIC WELLFIELD PROTECTION AREA SHALL BE FIFTY (50) GALLONS PER INCH PIPE DIAMETER PER MILE PER DAY FOR RESIDENTIAL LAND USE AND TWENTY (20) GALLONS PER INCH PIPE DIAMETER PER MILE PER DAY FOR NON-RESIDENTIAL LAND USE.
5. FORCE MAIN SEWERS CONSTRUCTED IN A PUBLIC WELLFIELD PROTECTION AREA SHALL BE EITHER DUCTILE IRON OR REINFORCED CONCRETE PRESSURE SEWER PIPES. FOR DUCTILE IRON PIPE EXFILTRATION RATE SHALL NOT BE GREATER THAN THE ALLOWABLE LEAKAGE RATE SPECIFIED IN AMERICAN WATER WORKS ASSOCIATION STANDARD (AWWA) C600-82 AT A TEST PRESSURE OF 100 PSI. FOR REINFORCED CONCRETE PRESSURE SANITARY SEWER EXFILTRATION RATE SHALL NOT BE GREATER THAN HALF (1/2) THE ALLOWABLE LEAKAGE RATE SPECIFIED IN AWWA C600-82 AT A TEST PRESSURE OF 100 PSI.
6. THE CONTRACTOR SHALL VERIFY NATURE, DEPTH, AND CHARACTER OF EXISTING UNDERGROUND UTILITIES PRIOR TO START OF CONSTRUCTION.
7. ALL OTHER PUBLIC OR PRIVATE UTILITY FACILITIES SHALL BE CONSTRUCTED AT LEAST 5 FEET FROM ANY WATER AND SEWER MAIN AS MEASURED FROM THE OUTSIDE BELL OF THE WATER OF THE UTILITY PIPE.
8. WHEN THE 5 FEET SEPARATION BETWEEN PROPOSED AND EXISTING LINE IS NOT POSSIBLE, THE CONTRACTOR SHALL HAND DIG OR EXPOSE THE WATER AND SEWER PIPES BEFORE PROCEEDING WITH POWER EQUIPMENT EXCAVATION.
9. IN NO CASE SHALL A CONTRACTOR INSTALL UTILITY PIPES, CONDUITS, CABLES, ETC. IN THE SAME TRENCH PARALLEL AND ABOVE AN EXISTING WATER OR SEWER PIPE EXCEPT WHERE THEY CROSS. ANY DEVIATION FROM NOTES 6, 7 AND 8 SHALL BE APPROVED IN WRITING BY THE RESPONSIBLE WATER AND SEWER UTILITY.
10. A NON-RESETTABLE ELAPSED TIME METER SHALL BE INSTALLED AT EACH PUMP TO RECORD THE TOTAL NUMBER OF OPERATING HOURS OF THE STATION.
11. IF ANY AREA OF THE WORK SITE IS FOUND TO CONTAIN BURIED SOLID WASTE AND/OR GROUND OR GROUND WATER CONTAMINATION, THE FOLLOWING SHALL APPLY:
  - A) ALL WORK IN THE AREA SHALL FOLLOW ALL APPLICABLE SAFETY REQUIREMENTS (E.G., OSHA, ETC.) AND NOTIFICATION MUST BE PROVIDED TO THE APPROPRIATE AGENCIES.
  - B) IMMEDIATELY NOTIFY THE ENVIRONMENTAL MONITORING AND RESTORATION DIVISION (EMRD). THE EMRD CAN BE CONTACTED AT (305) 372-6700.
  - C) IF CONTAMINATED SOILS AND/OR BURIED SOLID WASTE MATERIAL IS EXCAVATED DURING CONSTRUCTION, THEN THEY REQUIRE PROPER HANDLING AND DISPOSAL IN ACCORDANCE WITH THE LOCAL, STATE AND FEDERAL REGULATIONS. BE ADVISED THAT THE LANDFILL OWNER/OPERATOR IS THE FINAL AUTHORITY ON DISPOSAL AND MAY HAVE REQUIREMENTS BEYOND THOSE PROVIDED BY HEREIN. IF DISPOSAL WITHIN A MIAMI-DADE COUNTY OWNED LANDFILL (CLASS I LANDFILL) IS APPROPRIATE AND SELECTED, PLEASE CONTACT THE MIAMI-DADE COUNTY DEPARTMENT OF PUBLIC WORKS AND WASTE MANAGEMENT AT (305) 594-1670 FOR INFORMATION.
  - D) THE REUSE OF CONTAMINATED SOILS THAT ARE NOT RETURNED TO THE ORIGINAL EXCAVATION REQUIRES PRIOR APPROVAL OF A SOIL MANAGEMENT PLAN FROM THE ENVIRONMENTAL MONITORING AND RESTORATION DIVISION. THE EMRD CAN BE CONTACTED AT (305) 372-6700.




Call 811 or www.sunshine811.com two full business days before digging to have utilities located and marked.


Check positive response codes before you dig!

LAKEVIEW DISTRICT UTILITY CROSSINGS PREPARED FOR TOWN OF MEDLEY MIAMI-DADE FLORIDA	PROJECT NOTES (CONT'D)	KHA PROJECT 04-3637010 DATE FEB 2016 SCALE AS SHOWN DESIGNED BY BARTON J. FYE DRAWN BY AL/MRG CHECKED BY JEL	LICENSED PROFESSIONAL BARTON J. FYE FLORIDA LICENSE NUMBER 73898 2/18/2016	Kimley-Horn © 2016 KIMLEY-HORN AND ASSOCIATES, INC. 1221 BRICKELL AVENUE, SUITE 400, MIAMI, FL 33131 PHONE: 305-473-2025 WWW.KIMLEY-HORN.COM CA 0000696	DERM SEWER	2/1/2016
					CONSTRUCTION	2/17/2016
				REVISIONS	DATE	BY
				No.		



Plotted By: Fye, Barton Sheet Set/Installation of Water and Sewer Main Crossings. Layout: C-100 WATER AND SEWER KEY MAP February 18, 2016 03:25:01pm K:\MIA-ENV\043637010 - medley utility crossings (wa-0110.03)\CIVIL\CADD\plan\sheet\c-100 WATER AND SEWER KEY MAP.dwg  
This document, together with the concepts and designs presented herein, is intended only for the specific purpose and client for which it was prepared. Reuse of and improper reliance on this document without written authorization and adaptation by Kimley-Horn and Associates, Inc. shall be without liability to Kimley-Horn and Associates, Inc.

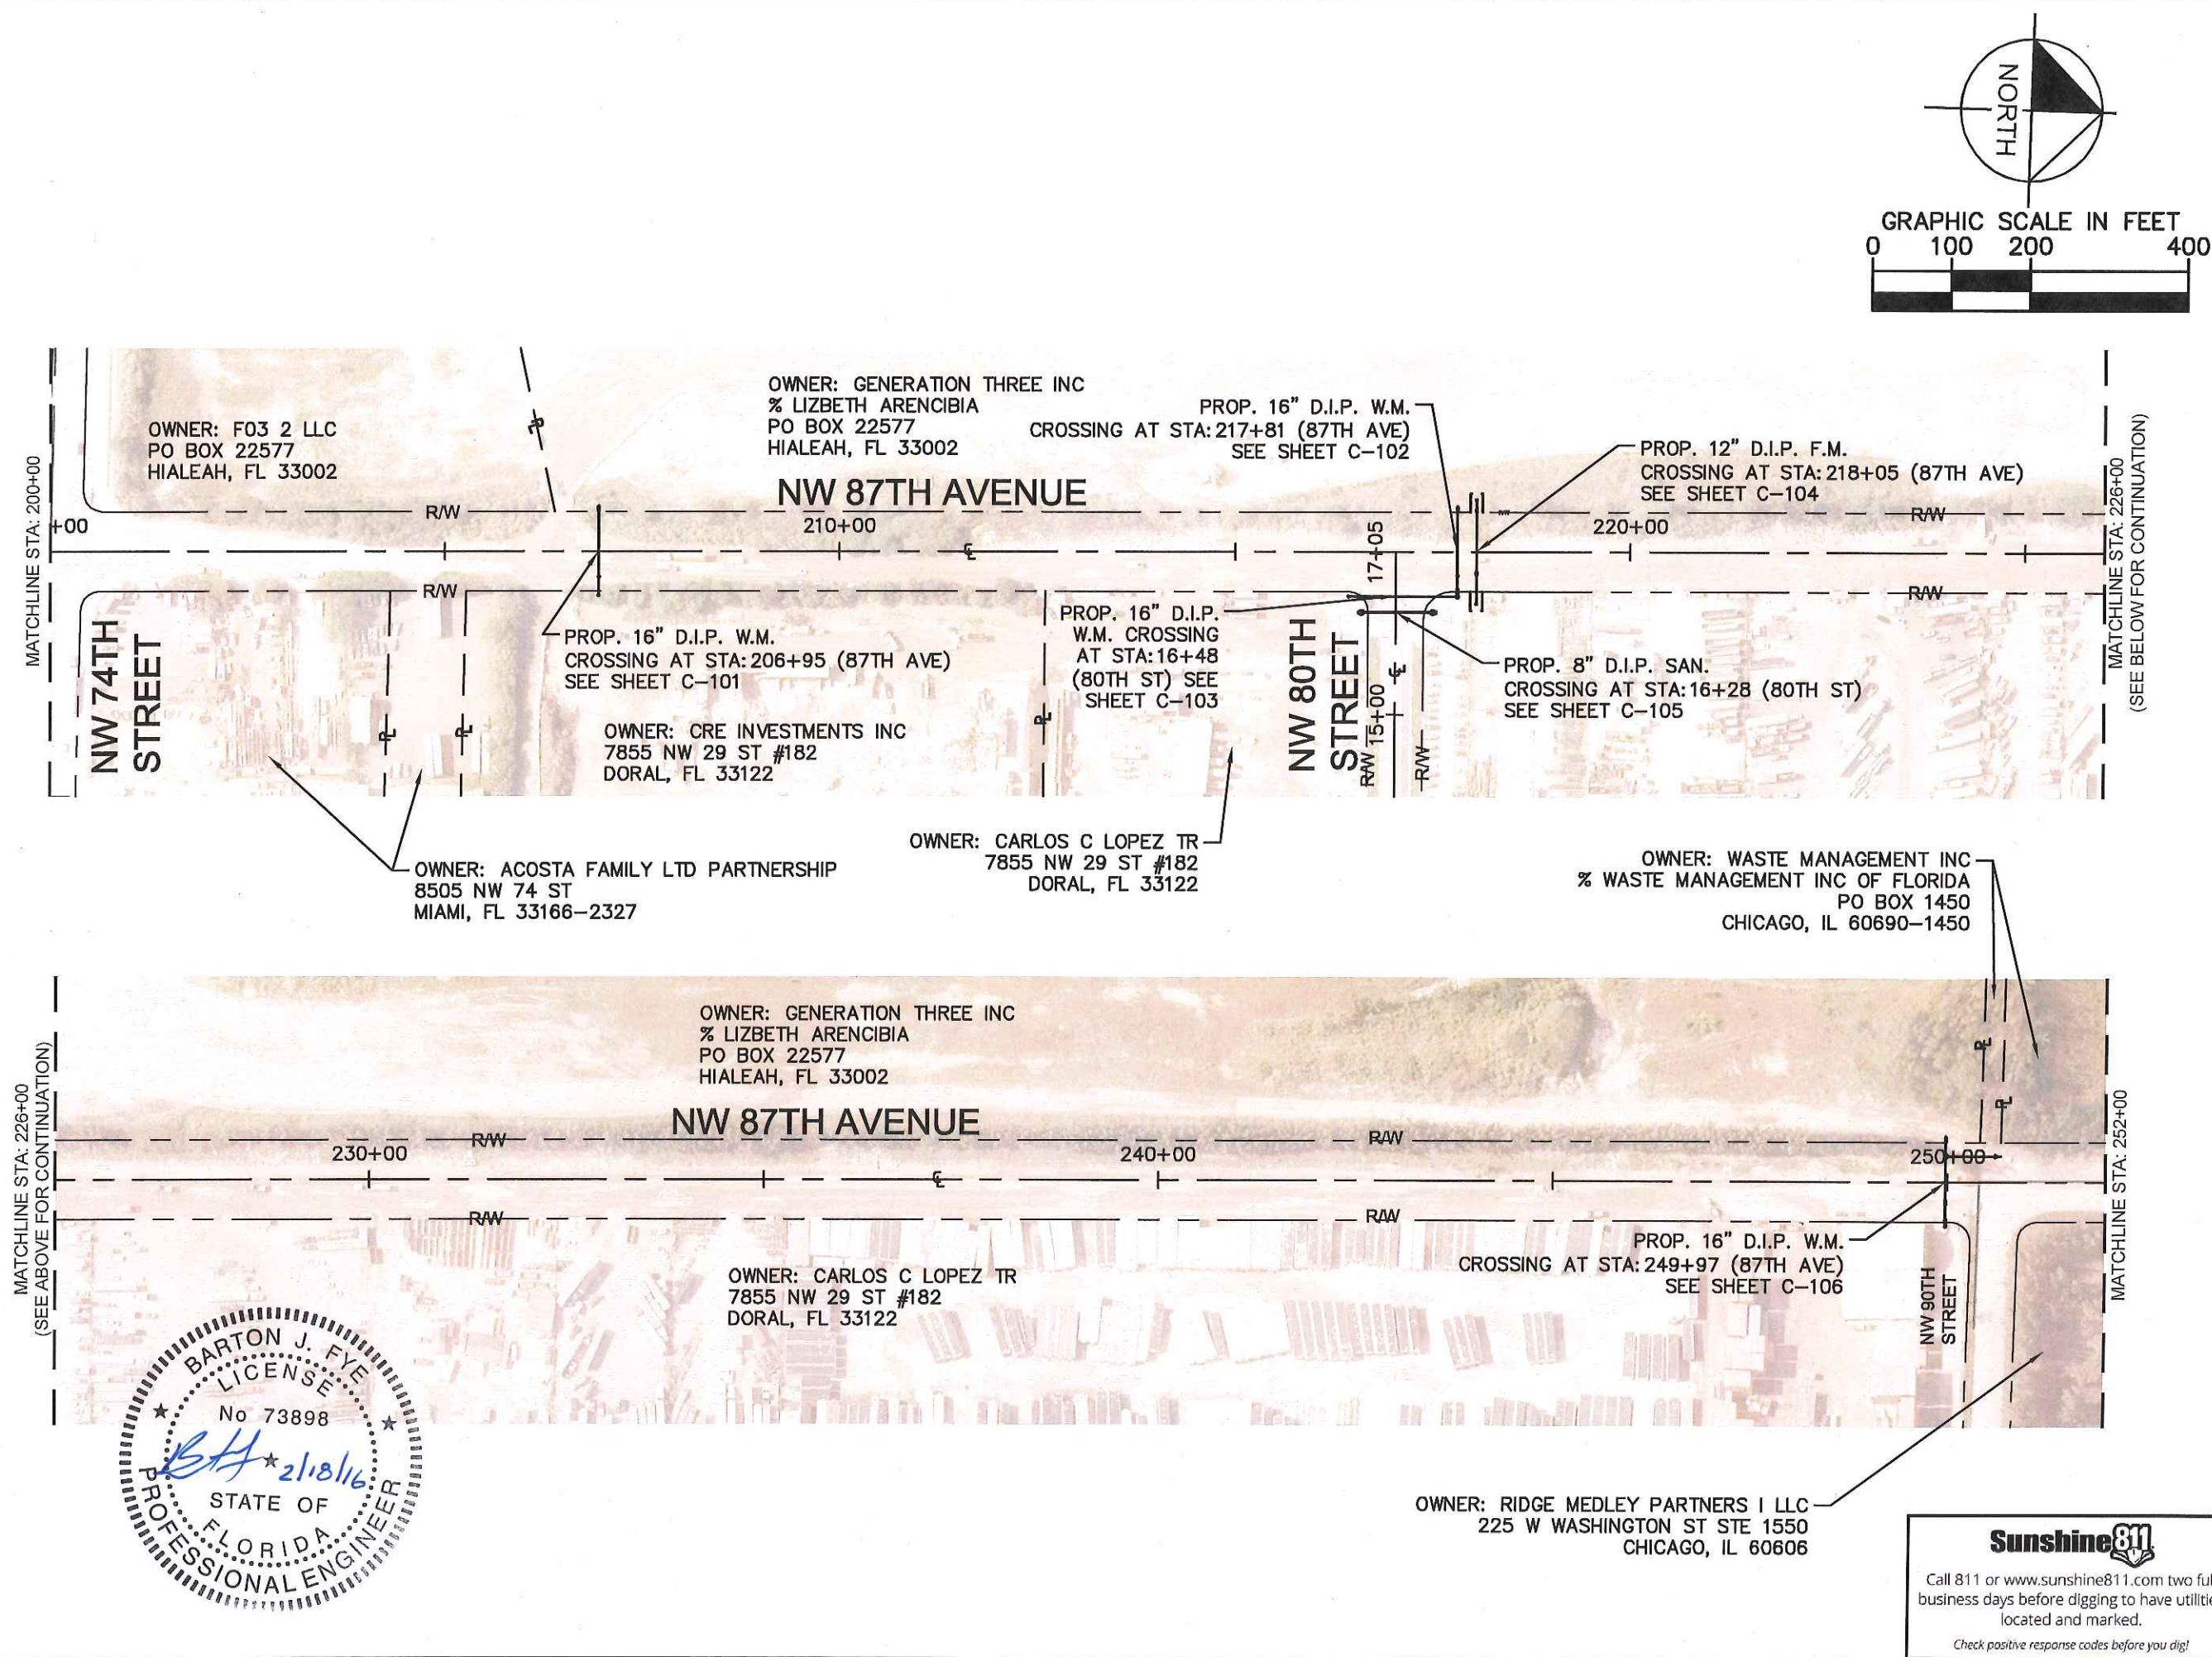



LAKEVIEW DISTRICT UTILITY CROSSINGS PREPARED FOR TOWN OF MEDLEY MIAMI-DADE FLORIDA	WATER AND SEWER KEY MAP	KHA PROJECT 043637010	LICENSED PROFESSIONAL		<div><p>© 2016 KIMLEY-HORN AND ASSOCIATES, INC. 1221 BRICKELL AVENUE, SUITE 400, MIAMI, FL 33131 PHONE: 305-873-2025 WWW.KIMLEY-HORN.COM CA 0000686</p></div>	DERM SEWER	2/1/2016	BY
		DATE FEB 2016	BARTON J. FYE	CONSTRUCTION		2/17/2016		
		SCALE AS SHOWN	FLORIDA LICENSE NUMBER 73898					
		DESIGNED BY BF	2/18/2016					
		DRAWN BY AL/MRG						
CHECKED BY JEL					No.	REVISIONS	DATE	BY
SHEET NUMBER C-100								







This document, together with the plans and specifications, shall constitute the contract between the owner and the contractor. It shall be the responsibility of the contractor to obtain all necessary permits and approvals from the appropriate authorities. The contractor shall be responsible for obtaining all necessary permits and approvals from the appropriate authorities. The contractor shall be responsible for obtaining all necessary permits and approvals from the appropriate authorities.

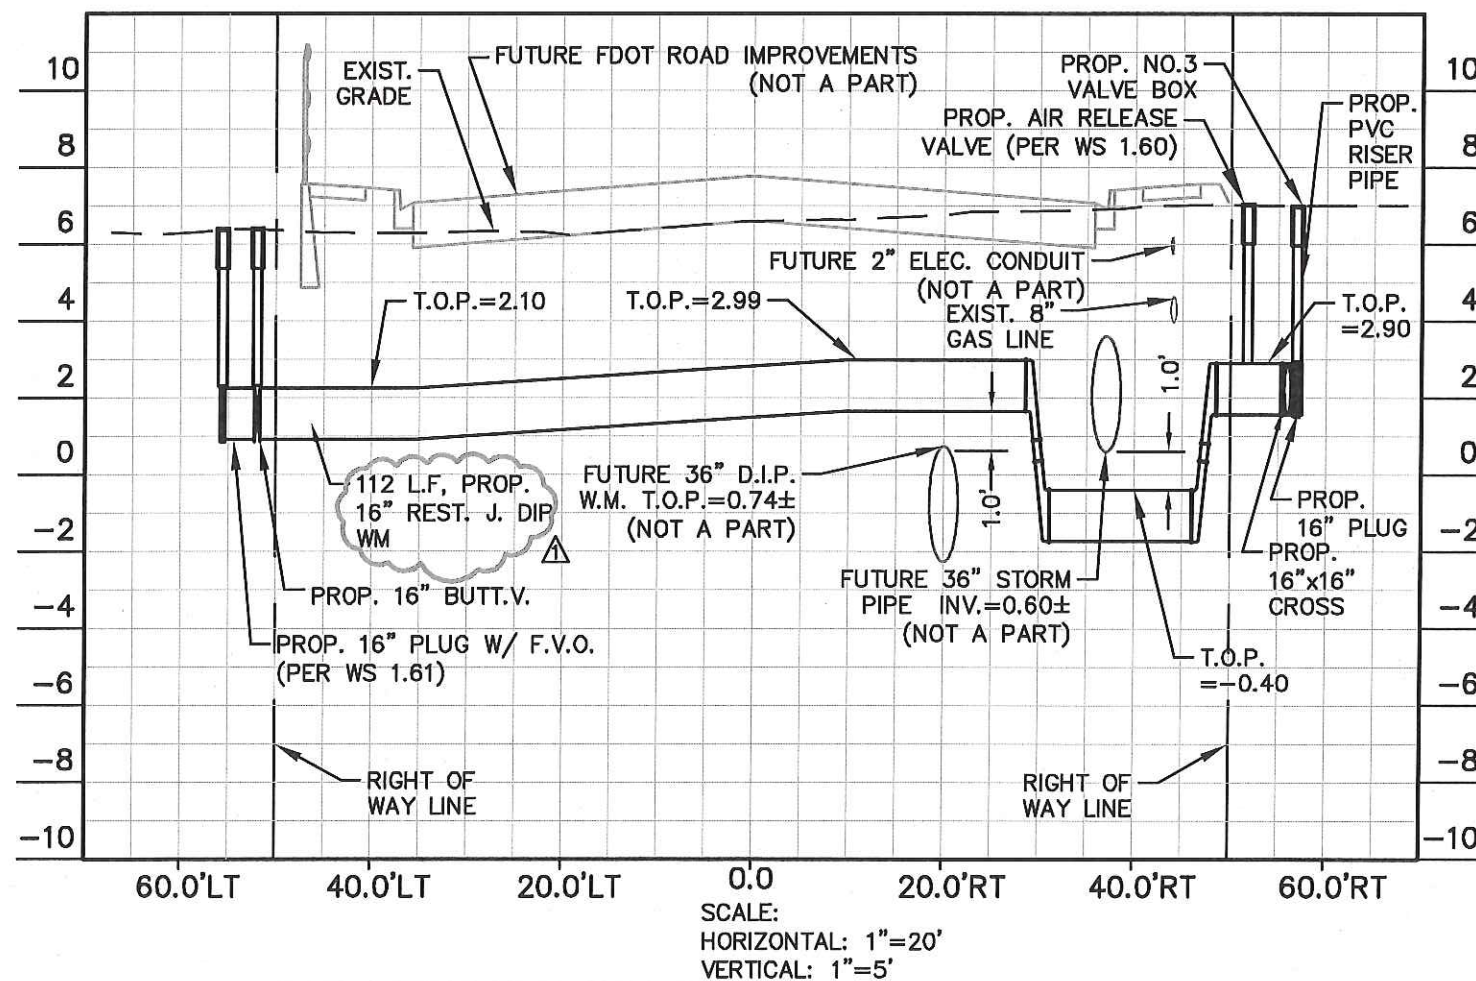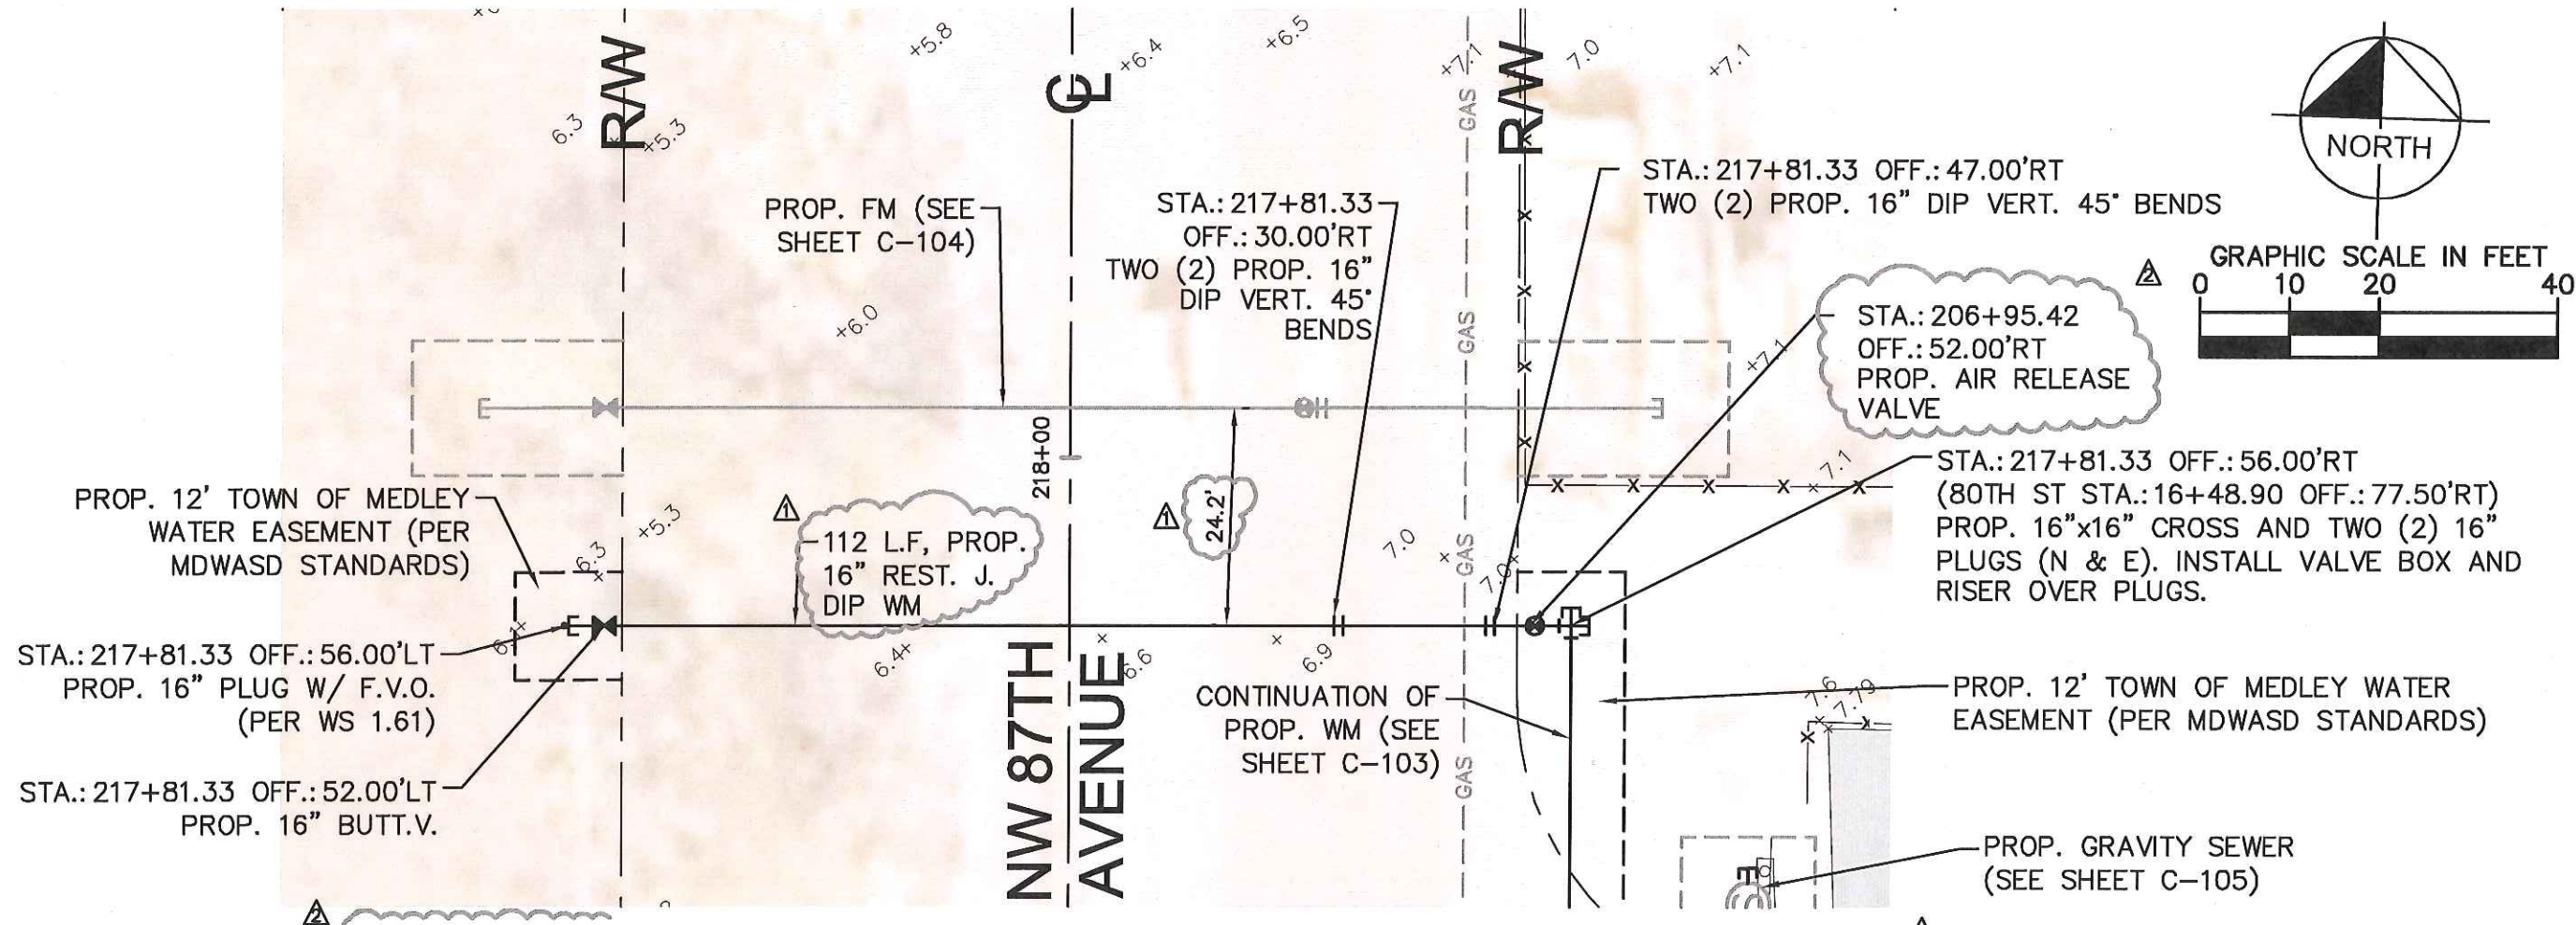

#### NOTES:

1. ALL TRENCH RESTORATION SHALL BE AS PER MDWASD STANDARDS TO 12" BELOW EXISTING GRADE. FINAL 12" OF BACKFILL SHALL BE COMPACTED LIMEROCK BASE (LBR 100) AS PER FDOT STANDARD SPECIFICATIONS FOR ROAD AND BRIDGE CONSTRUCTION SECTION 911.
2. ALL PROPOSED VALVE BOXES AND SANITARY MANHOLES IN UNPAVED AREAS SHALL HAVE REINFORCED CONC. SLAB AS PER SS 21.0.
3. COVER OVER ALL PROPOSED PIPE SHALL BE 48" UNLESS OTHERWISE DEPICTED. MIN. COVER SHALL BE 30" UNLESS REINFORCED CONC. SLAB PER GS 1.2 IS PROVIDED.
4. ALL PROPOSED PIPE SHALL BE CONSTRUCTED AT ELEVATIONS SHOWN UNLESS APPROVED IN WRITING BY THE EOR.
5. MIN. SEPARATION BETWEEN PROPOSED WATER MAIN AND OTHER UTILITIES SHALL BE AS PER MDWASD STANDARD DETAIL GS 1.5.



Call 811 or [www.sunshine811.com](http://www.sunshine811.com) two full business days before digging to have utilities located and marked.

Check positive response codes before you dig!

DATE	BY	REVISIONS	No.
2/17/2016	BUF	CONSTRUCTION	
2/1/2016	BUF		

LAKEVIEW DISTRICT UTILITY CROSSINGS PREPARED FOR TOWN OF MEDLEY	FLORIDA MIAMI-DADE
--	-----------------------

KHA PROJECT 04-3637010	DATE FEB 2016	SCALE AS SHOWN DESIGNED BY DRAWN BY AL/MRG	CHECKED BY JEF
---------------------------	------------------	--	-------------------

LICENSED PROFESSIONAL	BARTON J. FYE	FLORIDA LICENSE NUMBER 73898	2/18/2016
-----------------------	---------------	---------------------------------	-----------



<b>Kimley-Horn</b>	© 2016 KIMLEY-HORN AND ASSOCIATES, INC. 1221 BRICKELL AVENUE, SUITE 400, MIAMI, FL 33131 PHONE: 305-473-2025 WWW.KIMLEY-HORN.COM
--------------------	---








This document, together with the concepts and designs presented herein, is an instrument of service, and its preparation and use are subject to the terms and conditions of the contract between the client and the engineer. The engineer shall be held liable to the client for any errors or omissions in this document without written authorization and adaptation by Kimley-Horn and Associates, Inc. shall be without liability to Kimley-Horn and Associates, Inc.

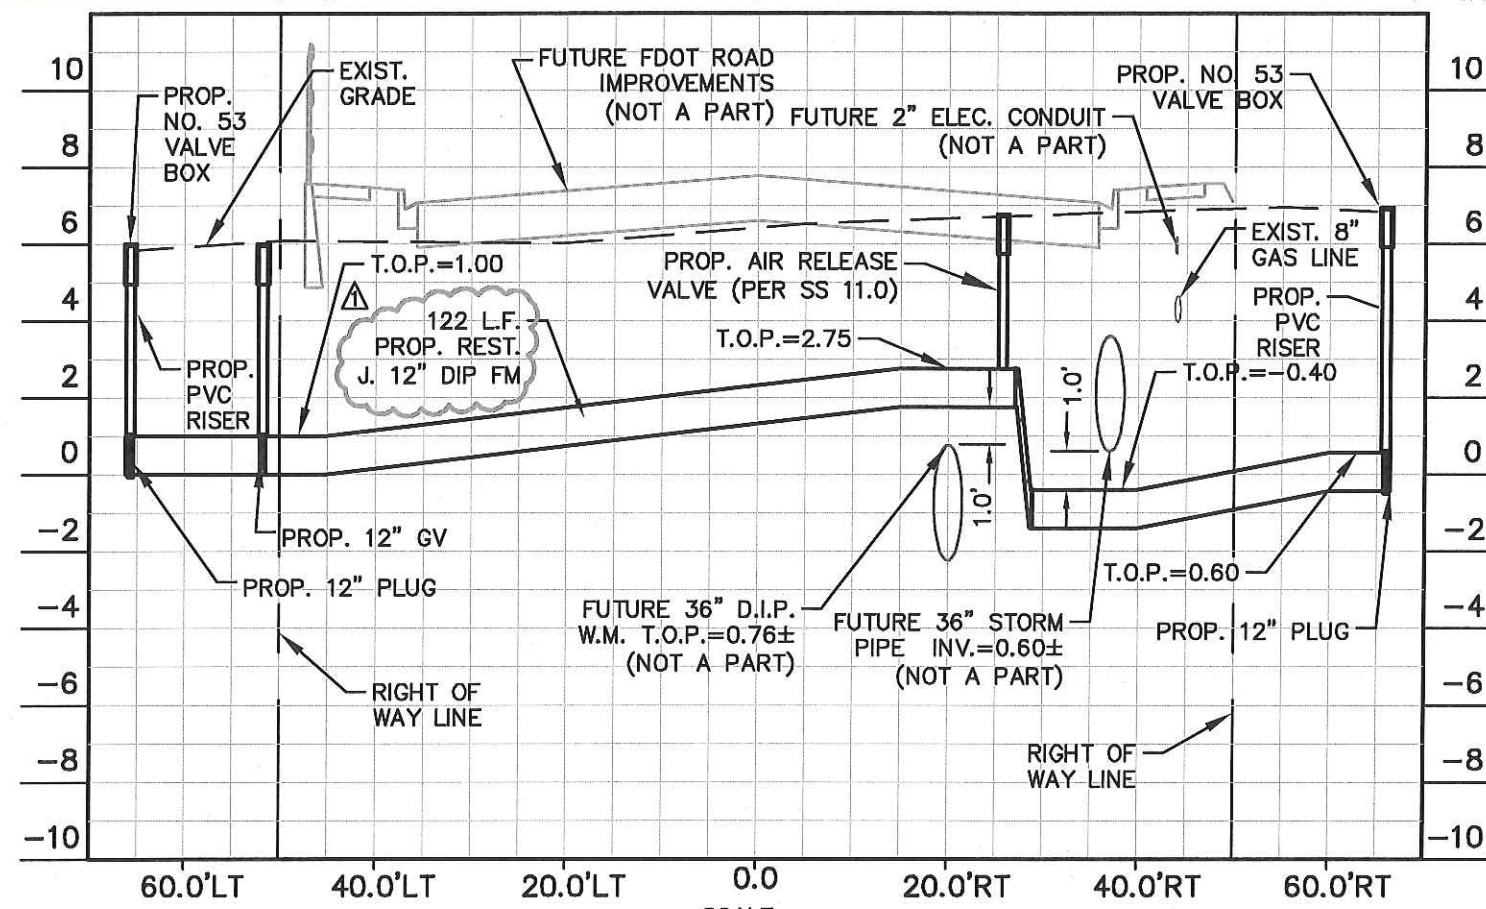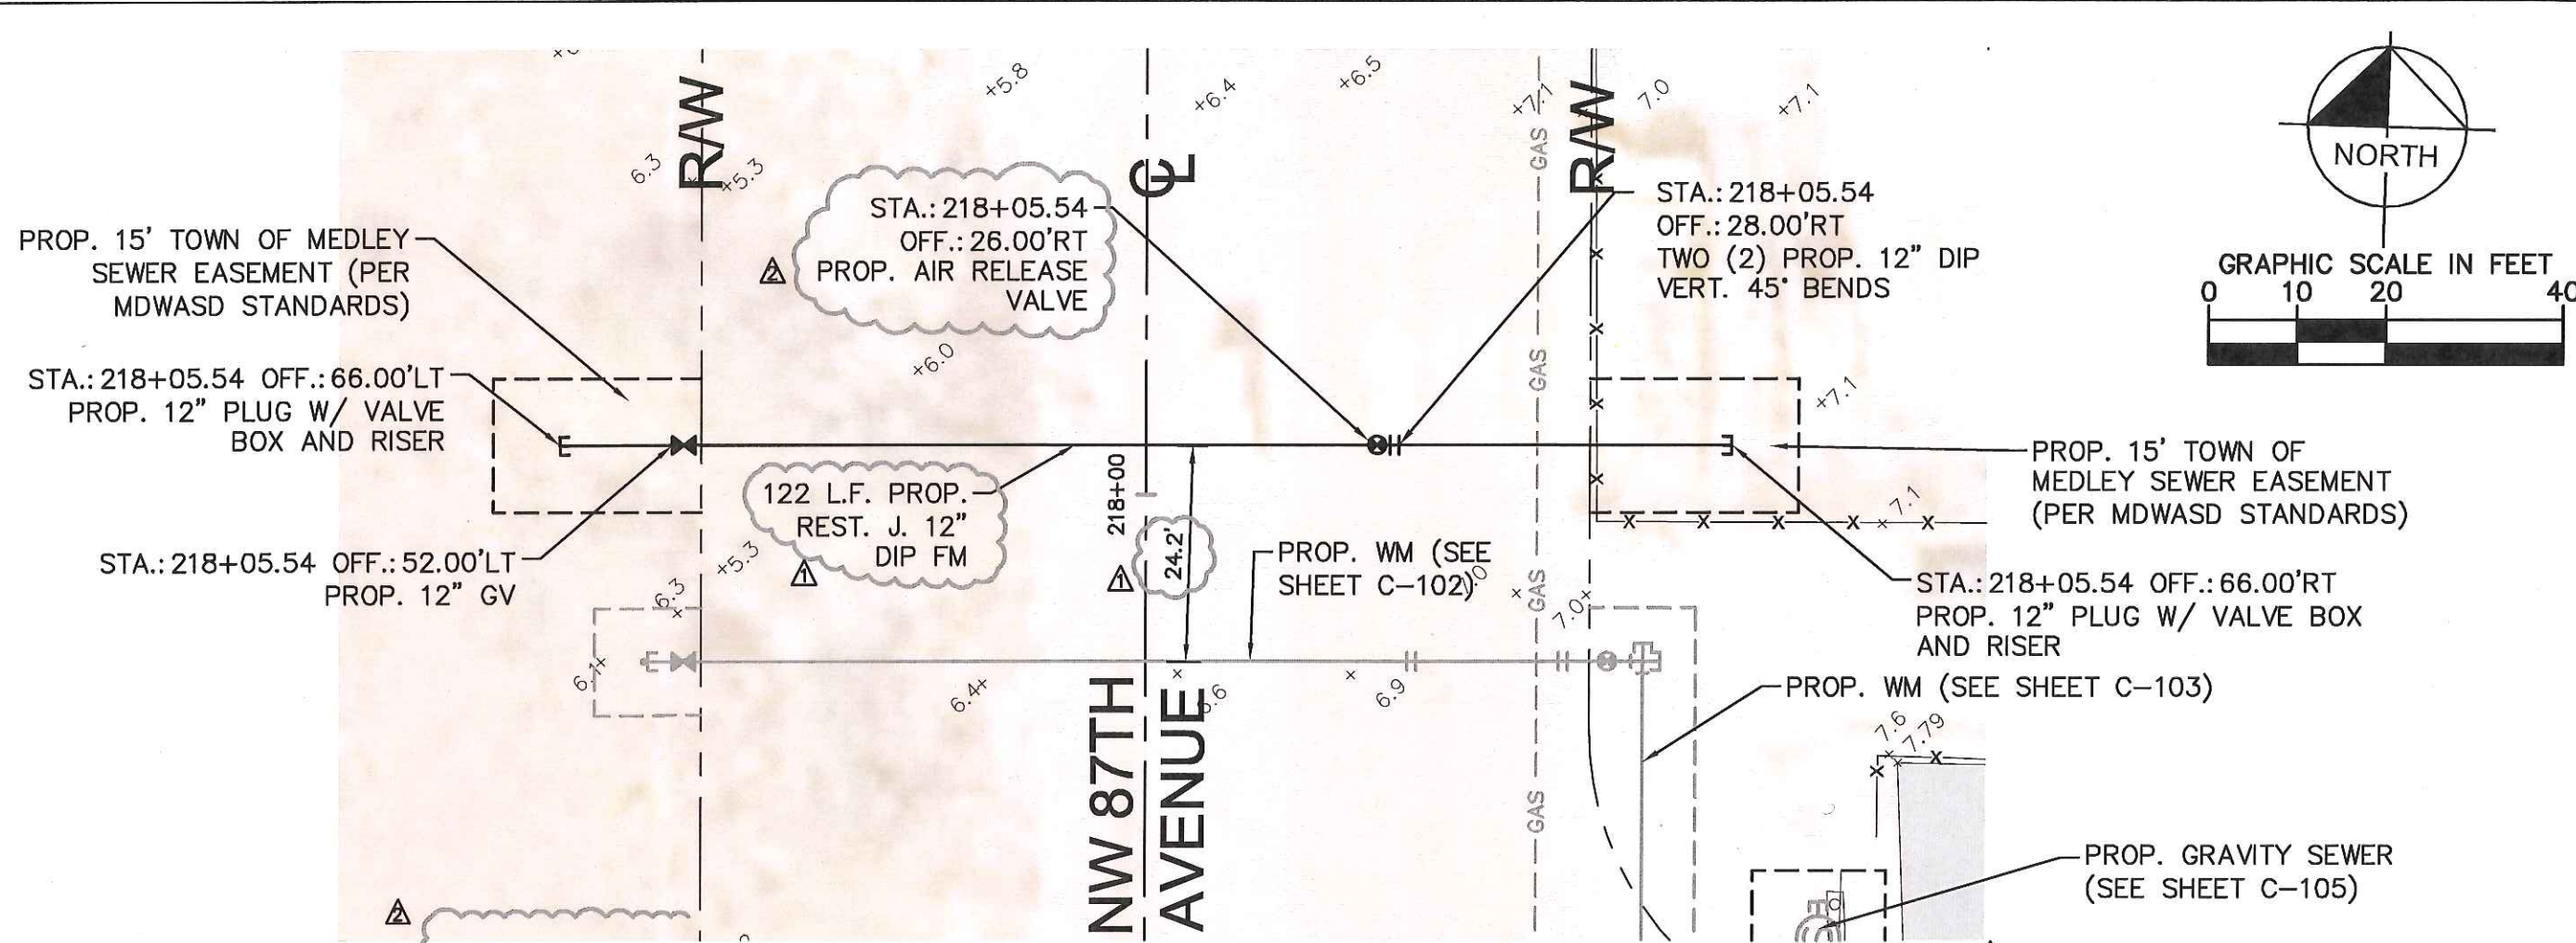


- NOTES: Δ
1. ALL TRENCH RESTORATION SHALL BE AS PER MDWASD STANDARDS TO 12" BELOW EXISTING GRADE. FINAL 12" OF BACKFILL SHALL BE COMPACTED LIMEROCK BASE (LBR 100) AS PER FDOT STANDARD SPECIFICATIONS FOR ROAD AND BRIDGE CONSTRUCTION SECTION 911.
  2. ALL PROPOSED VALVE BOXES AND SANITARY MANHOLES IN UNPAVED AREAS SHALL HAVE REINFORCED CONC. SLAB AS PER SS 21.0.
  - Δ 3. COVER OVER ALL PROPOSED PIPE SHALL BE 48" UNLESS OTHERWISE DEPICTED. MIN. COVER SHALL BE 30" UNLESS REINFORCED CONC. SLAB PER GS 1.2 IS PROVIDED.
  4. ALL PROPOSED PIPE SHALL BE CONSTRUCTED AT ELEVATIONS SHOWN UNLESS APPROVED IN WRITING BY THE EOR.
  5. MIN. SEPARATION BETWEEN PROPOSED WATER MAIN AND OTHER UTILITIES SHALL BE AS PER MDWASD STANDARD DETAIL GS 1.5.

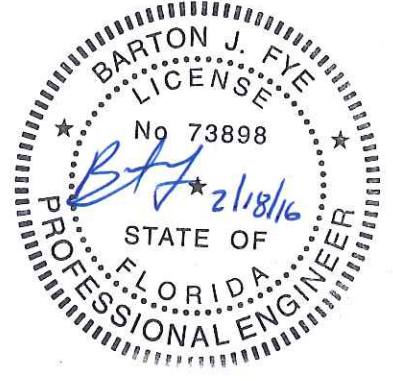

**Sunshine811**

Call 811 or [www.sunshine811.com](http://www.sunshine811.com) two full business days before digging to have utilities located and marked.

Check positive response codes before you dig!




SHEET NUMBER <b>C-104</b>	LAKEVIEW DISTRICT UTILITY CROSSINGS  PREPARED FOR TOWN OF MEDLEY  MIAMI-DADE  FLORIDA	SITE "B" FORCE MAIN PLAN AND PROFILE	KHA PROJECT 043637010	LICENSED PROFESSIONAL	 © 2016 KIMLEY-HORN AND ASSOCIATES, INC. 1221 BRICKELL AVENUE, SUITE 400, MIAMI, FL 33131 PHONE: 305-473-2025 WWW.KIMLEY-HORN.COM CA 0000696	DERM SEWER CONSTRUCTION	2/1/2016	BY
			DATE FEB 2016	BARTON J. FYE		2/17/2016		
			SCALE AS SHOWN	FLORIDA LICENSE NUMBER 73898				
			DESIGNED BY BF	2/18/2016				
			DRAWN BY AL/MRG					
			CHECKED BY JEL		No.	REVISIONS	DATE	







This document, together with the concepts and designs presented herein, as an instrument of service, is intended only for the specific purpose and client for which it was prepared. Reuse of and improper reliance on this document without written authorization and adaptation by Kimley-Horn and Associates, Inc. will be without liability to Kimley-Horn and Associates, Inc.

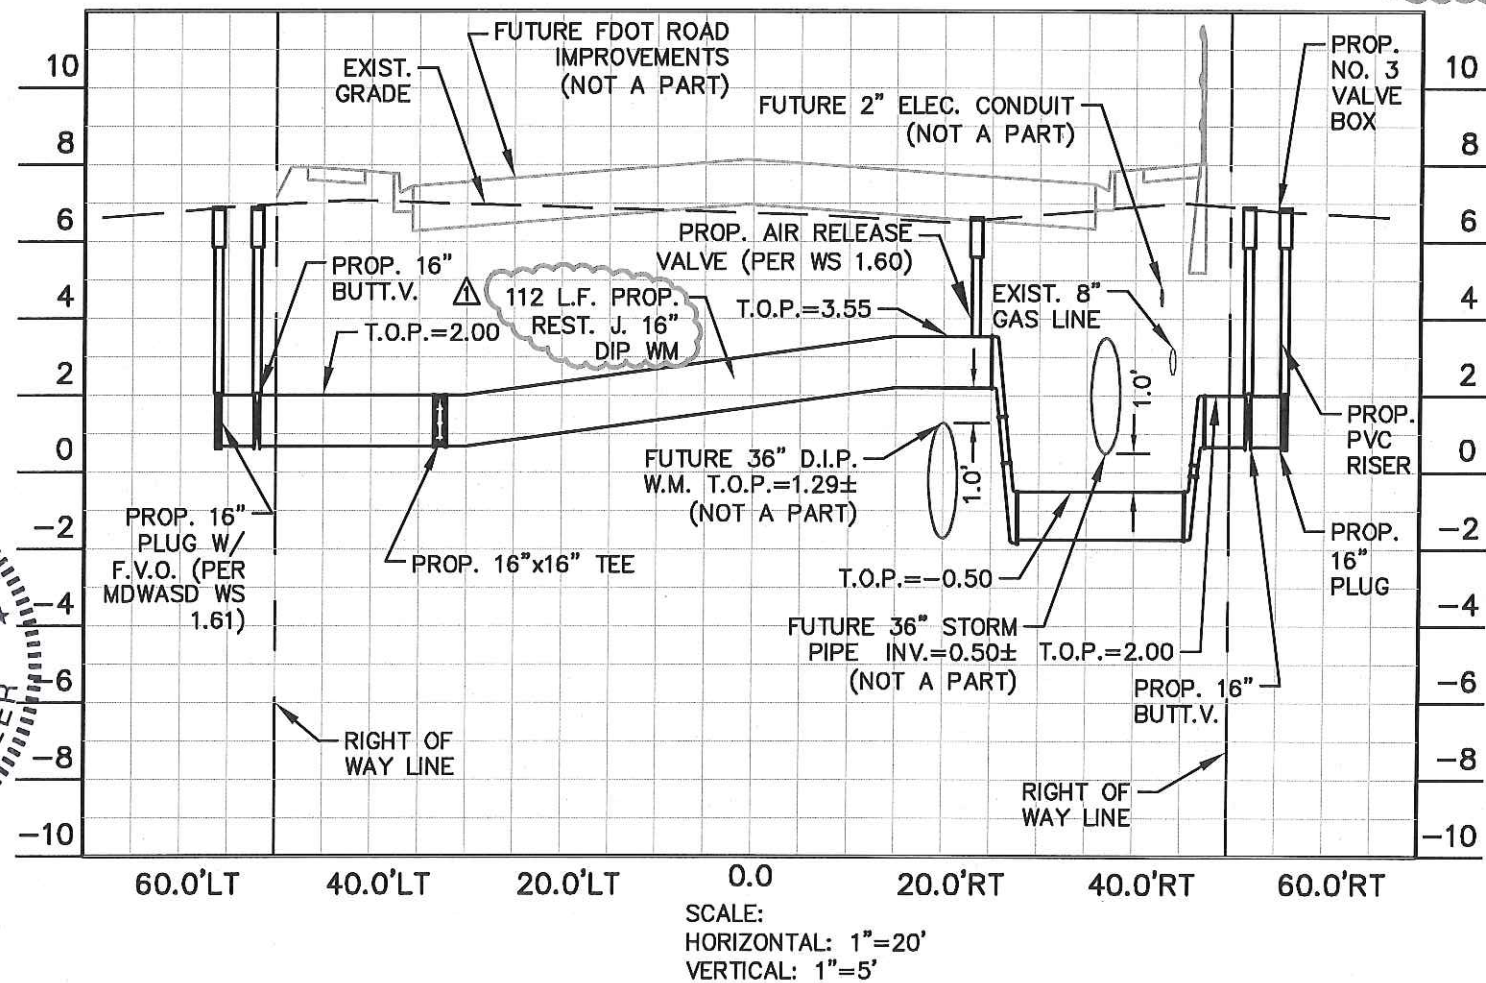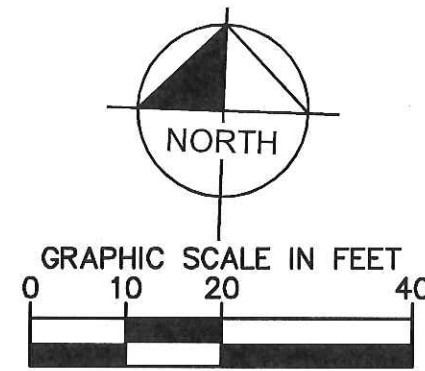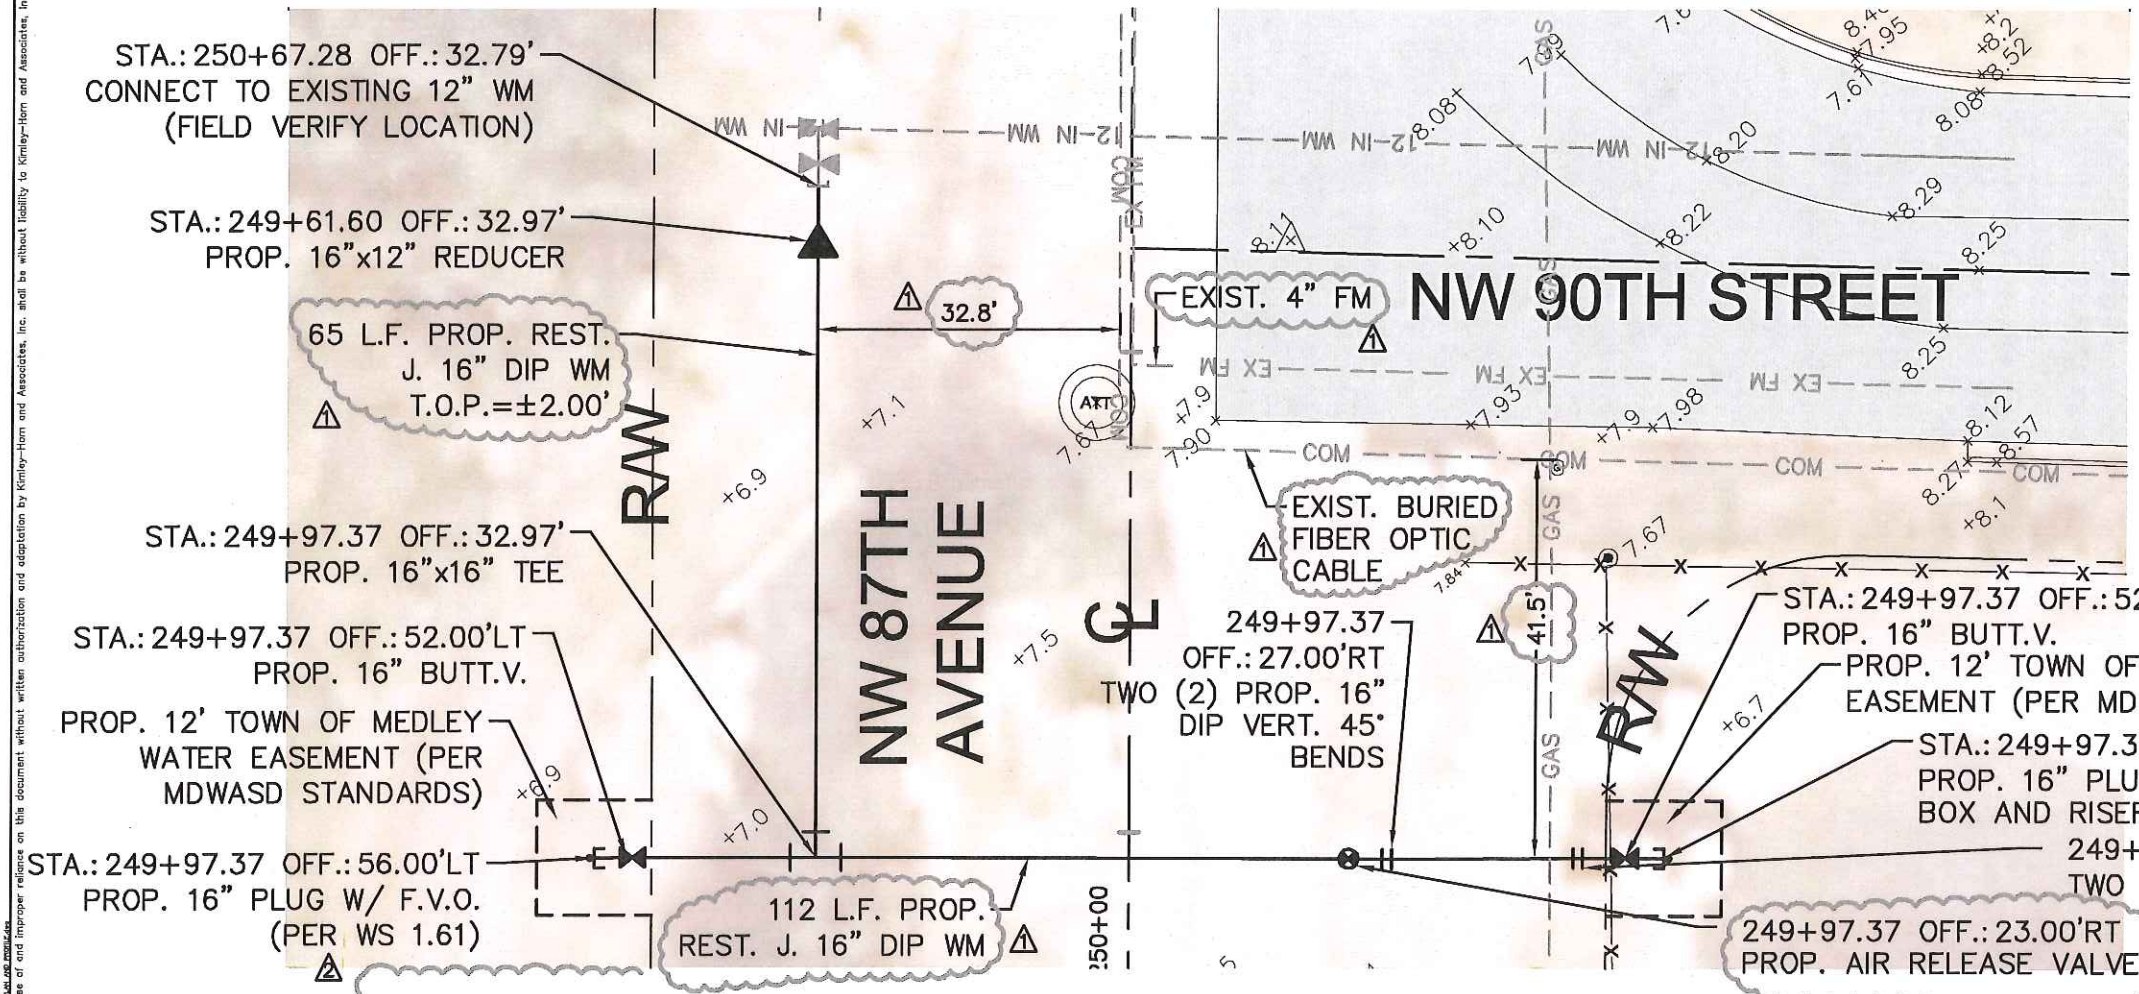

- NOTES:  $\Delta$
1. ALL TRENCH RESTORATION SHALL BE AS PER MDWASD STANDARDS TO 12" BELOW EXISTING GRADE. FINAL 12" OF BACKFILL SHALL BE COMPACTED LIMEROCK BASE (LBR 100) AS PER FDOT STANDARD SPECIFICATIONS FOR ROAD AND BRIDGE CONSTRUCTION SECTION 911.
  2. ALL PROPOSED VALVE BOXES AND SANITARY MANHOLES IN UNPAVED AREAS SHALL HAVE REINFORCED CONC. SLAB AS PER SS 21.0.
  - $\Delta$  3. COVER OVER ALL PROPOSED PIPE SHALL BE 48" UNLESS OTHERWISE DEPICTED. MIN. COVER SHALL BE 30" UNLESS REINFORCED CONC. SLAB PER GS 1.2 IS PROVIDED.
  4. ALL PROPOSED PIPE SHALL BE CONSTRUCTED AT ELEVATIONS SHOWN UNLESS APPROVED IN WRITING BY THE EOR.
  5. MIN. SEPARATION BETWEEN PROPOSED WATER MAIN AND OTHER UTILITIES SHALL BE AS PER MDWASD STANDARD DETAIL GS 1.5.

**Sunshine811**  
Call 811 or www.sunshine811.com two full business days before digging to have utilities located and marked.  
Check positive response codes before you dig!

DATE	2/17/2016	BY	
REVISIONS			
No.			
<b>Kimley-Horn</b> © 2016 KIMLEY-HORN AND ASSOCIATES, INC. 1221 BRICKELL AVENUE, SUITE 400, MIAMI, FL 33131 PHONE: 305-573-2025 WWW.KIMLEY-HORN.COM CA 0000686			
LICENSED PROFESSIONAL	BARTON J. FYE	FLORIDA LICENSE NUMBER	73898
KHA PROJECT	04-3637010	DATE	FEB 2016
SCALE	AS SHOWN	DESIGNED BY	BF
DRAWN BY	AL/MRG	CHECKED BY	JEL
LAKEVIEW DISTRICT UTILITY CROSSINGS PREPARED FOR TOWN OF MEDLEY FLORIDA MIAMI-DADE			
SHEET NUMBER C-106			